


# 1815 E. HEIM AVENUE ORANGE, CALIFORNIA

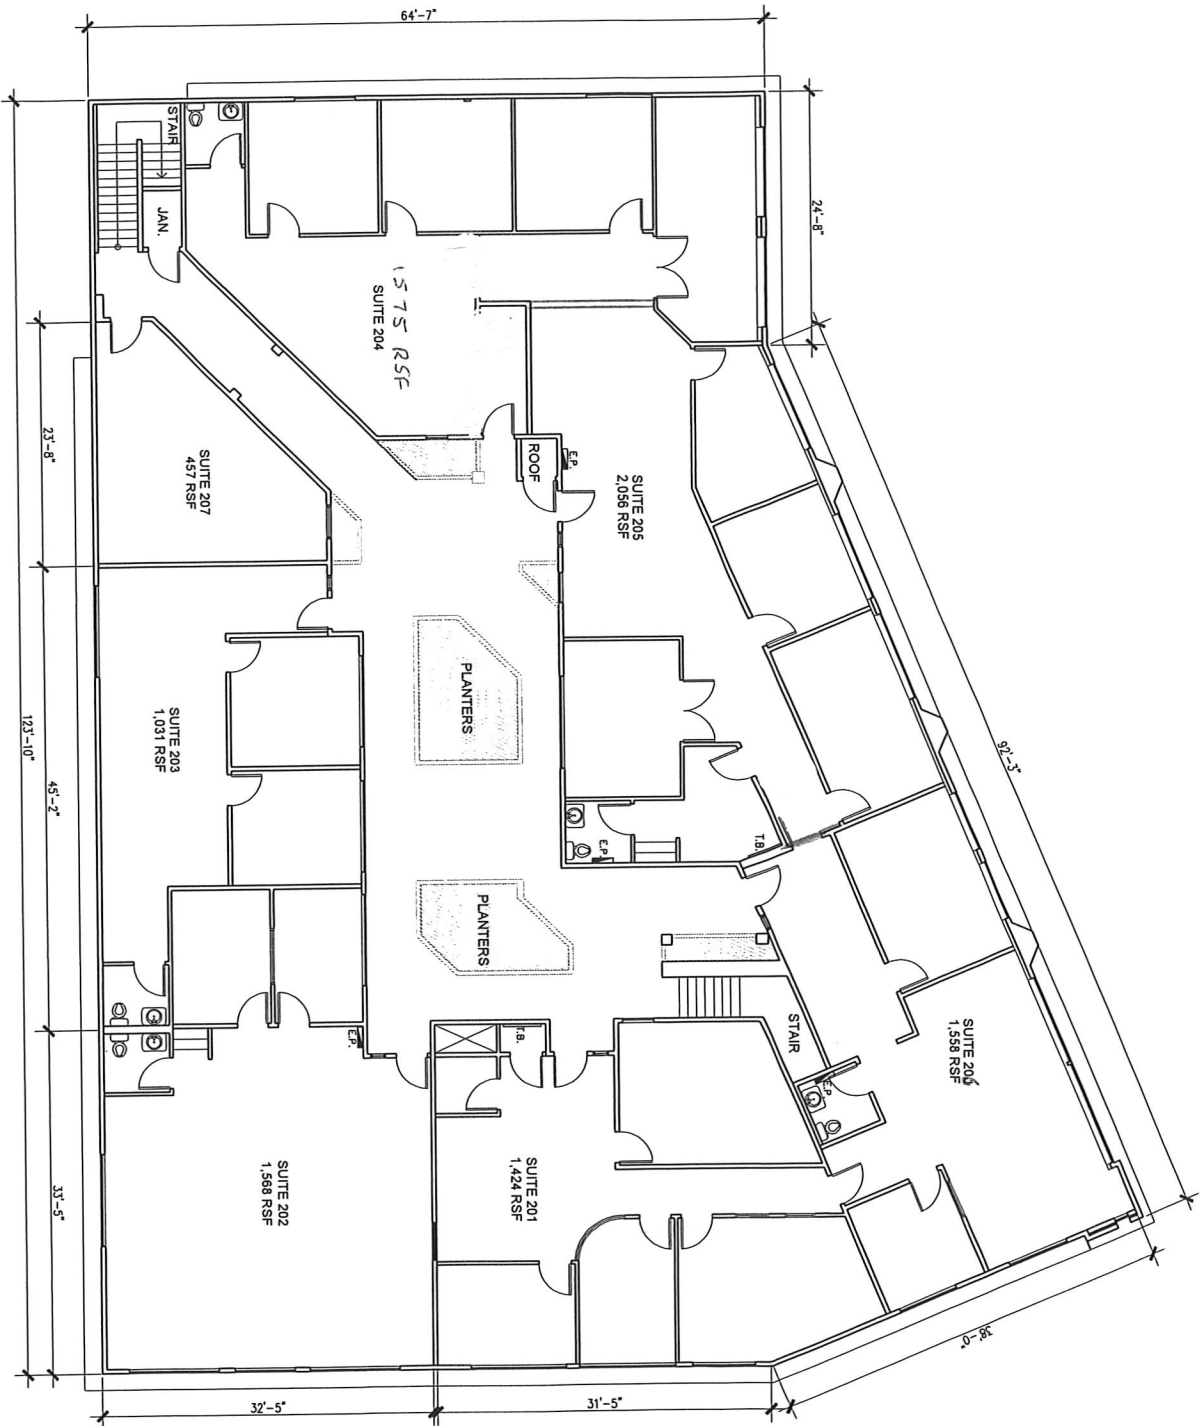

## SECOND FLOOR ASBUILT PLAN




Cadtronics, Inc. does not warrant that the information contained herein represents "As-Built" or existing field conditions. The Lease Outline Drawing is provided for reference purposes only. All information and conditions must be field verified by Tenant's architect and contractor.



**CADTRONICS**  
949.251.1710

# 1815 E. HEIM AVENUE ORANGE, CALIFORNIA

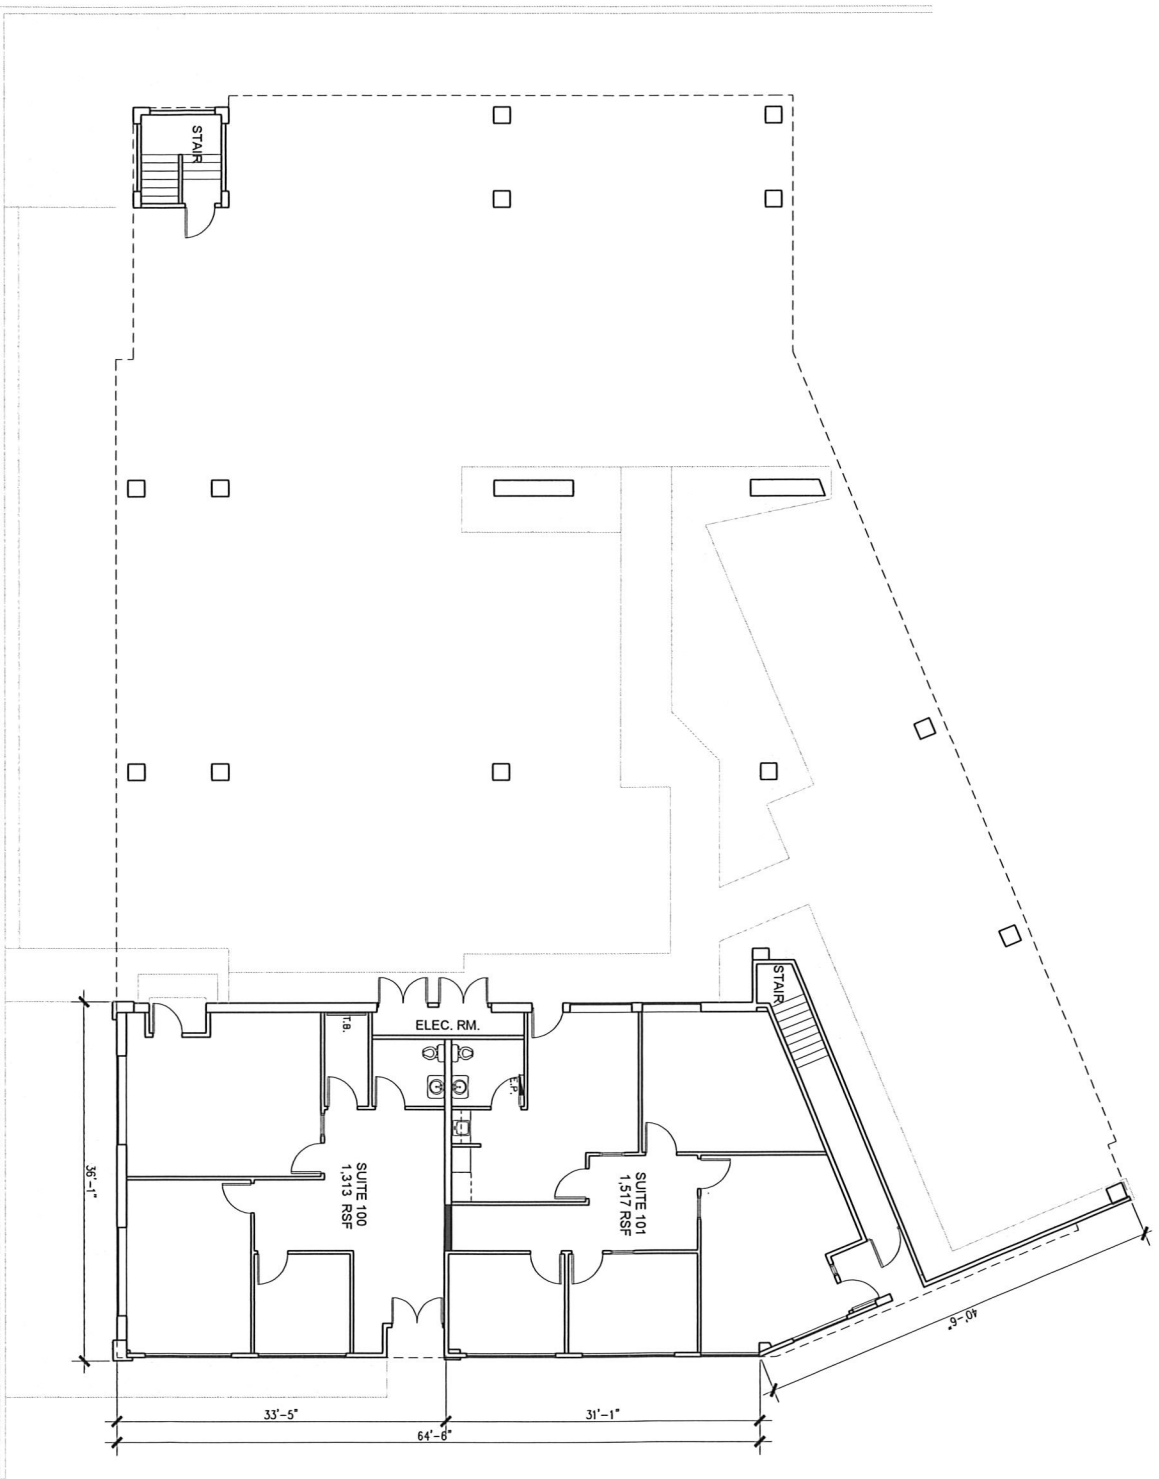

FIRST FLOOR ASBUILT PLAN



Cadtronics, Inc. does not warrant that the information contained herein represents "As-Built" or existing field conditions. The Lease Outline Drawing is provided for reference purposes only. All information and conditions must be field verified by Tenant's architect and contractor.



CADTRONICS  
949.251.1710